Tevatron BPM Filter Card
Front Panel

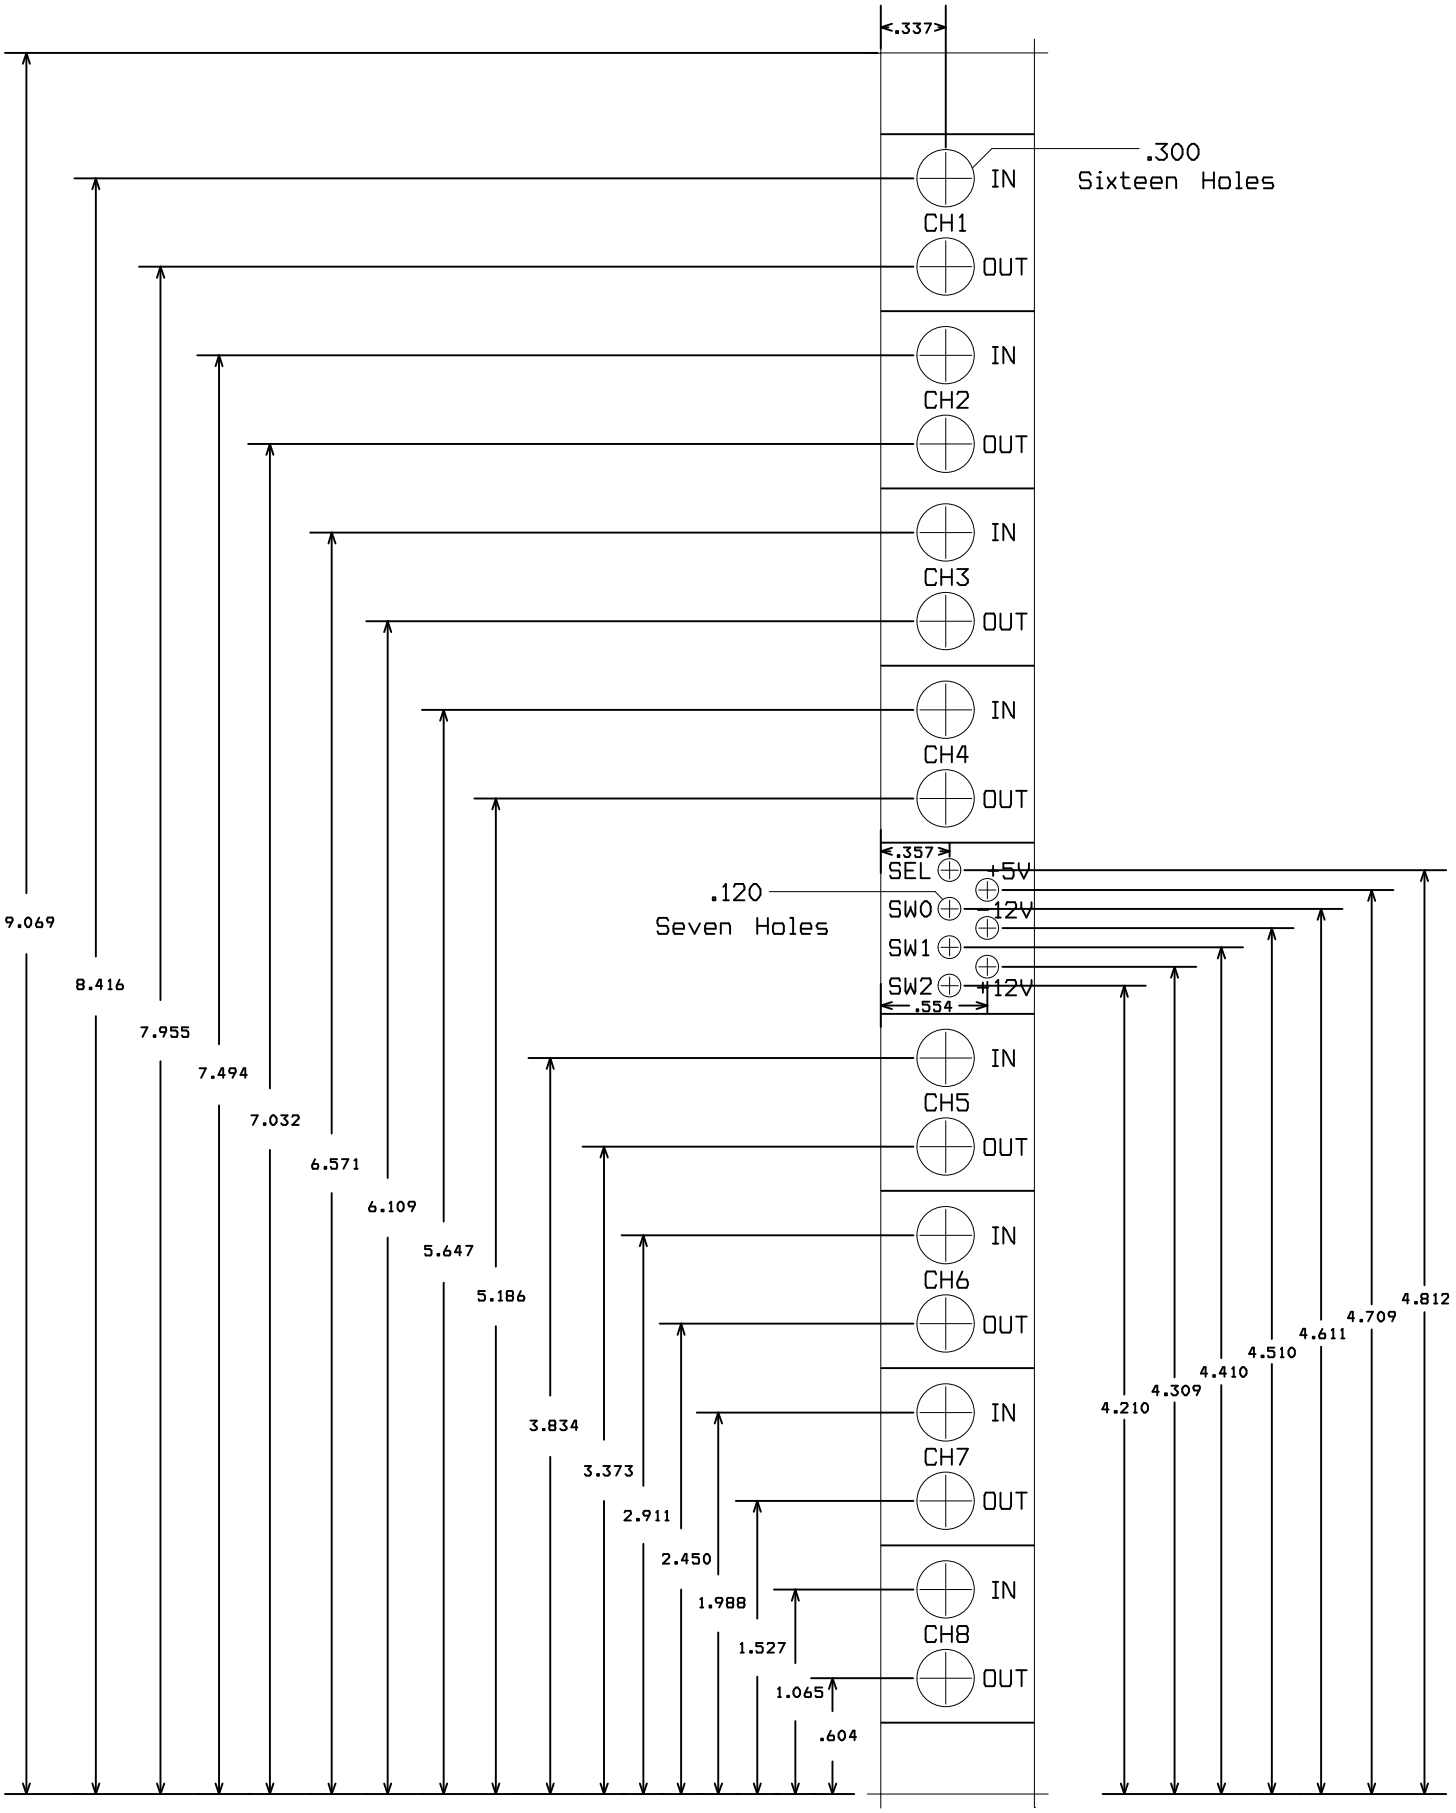

All Dimensions are in inches.

IN

CH1

OUT

IN

CH2

OUT

IN

CH3

OUT

IN

CH4

OUT

SEL	+5V
SW0	-12V
SW1	
SW2	+12V

IN

CH5

OUT

IN

CH6

OUT

IN

CH7

OUT

IN

CH8

OUT

Tevatron BPM Filter Card
Front Panel

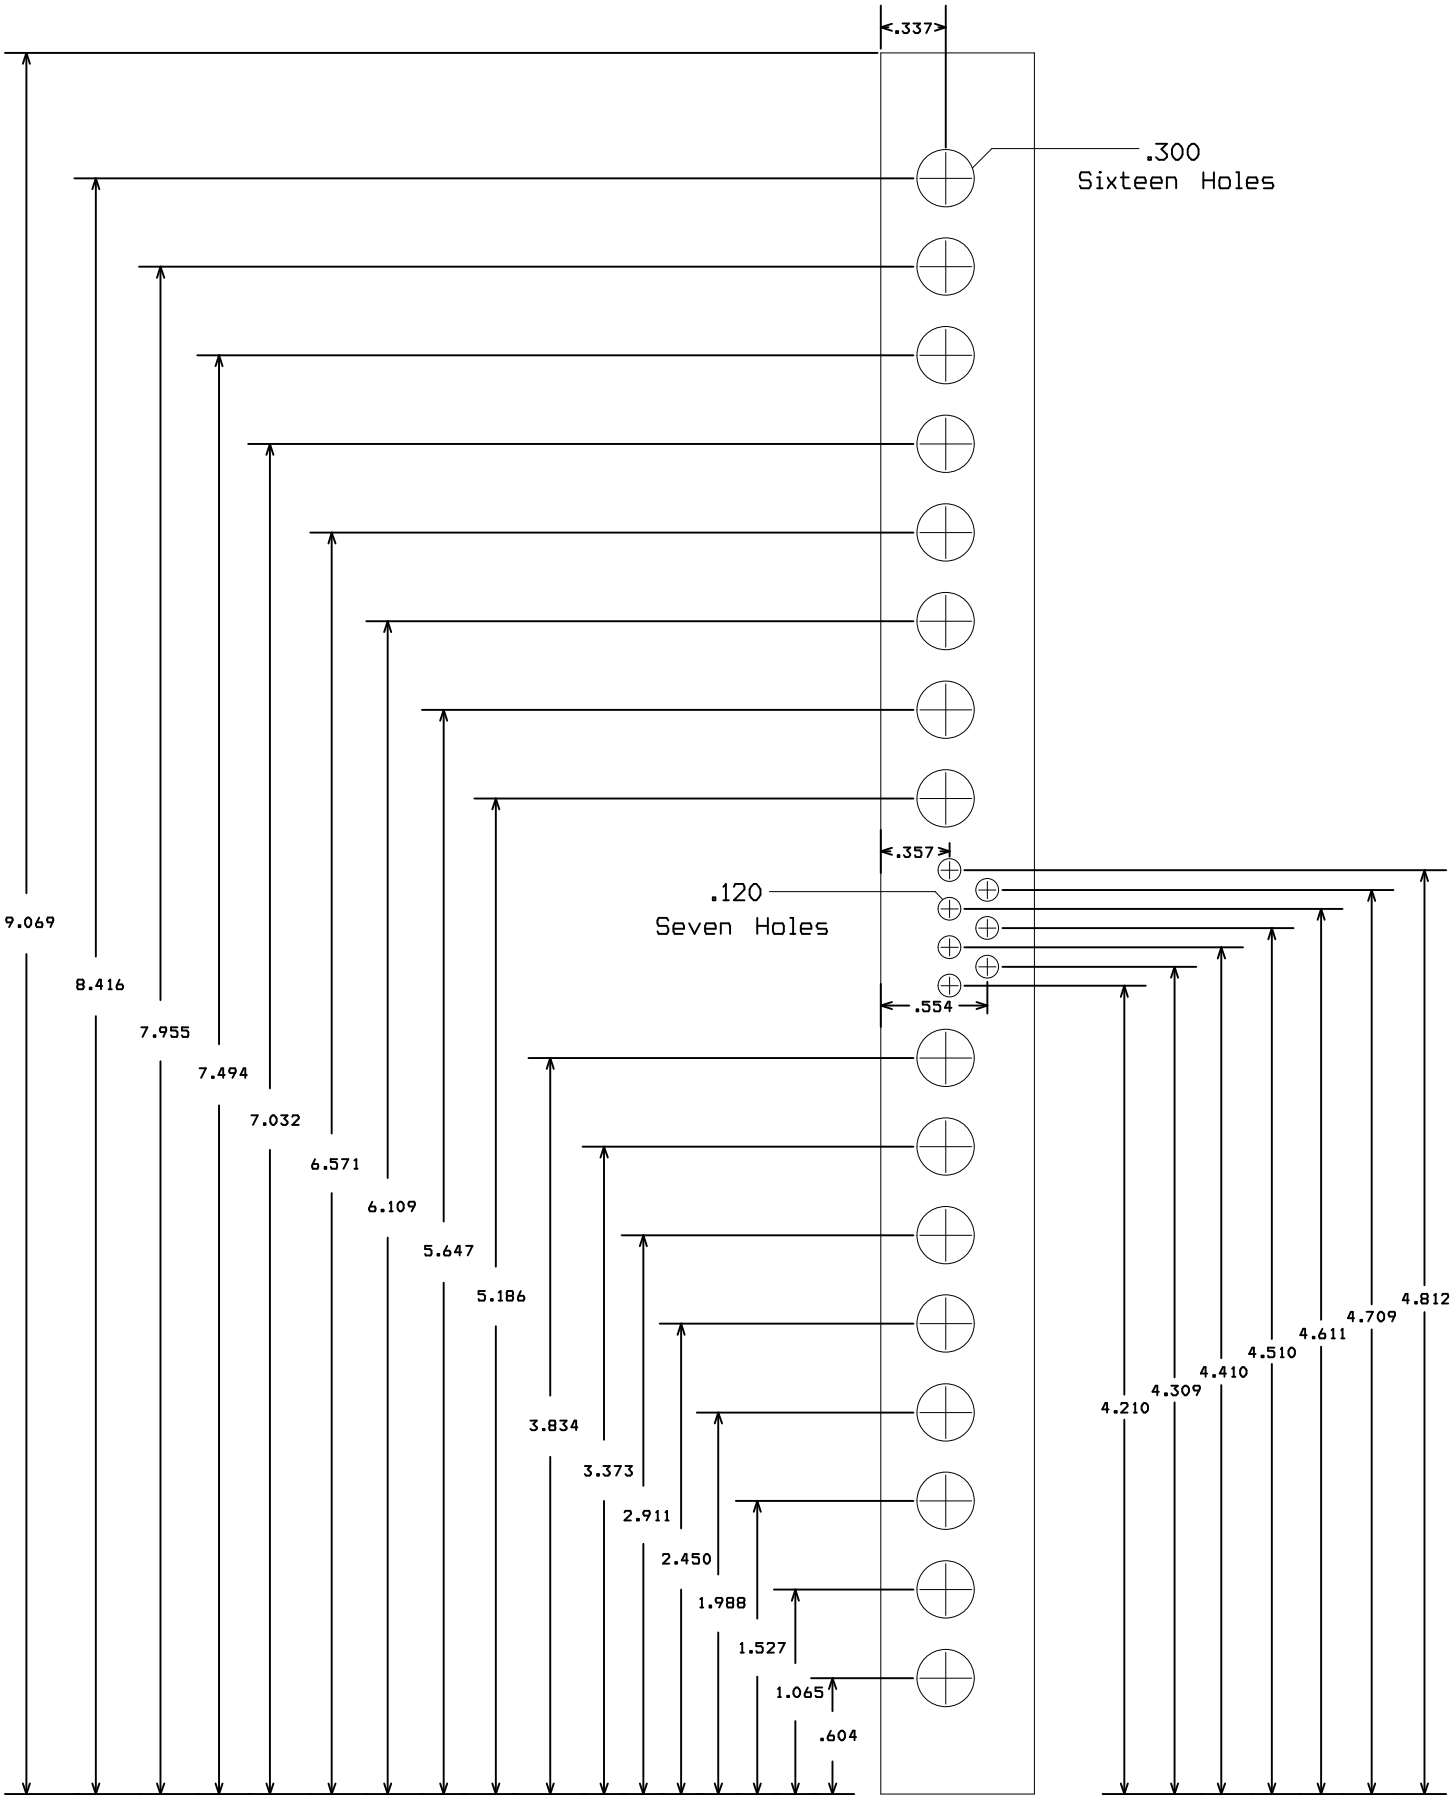

All Dimensions are in inches.